 



Front Elevation
Facing Cardiff Road

Side Elevation
On Arrow B


Rear Elevation



Roof Plan

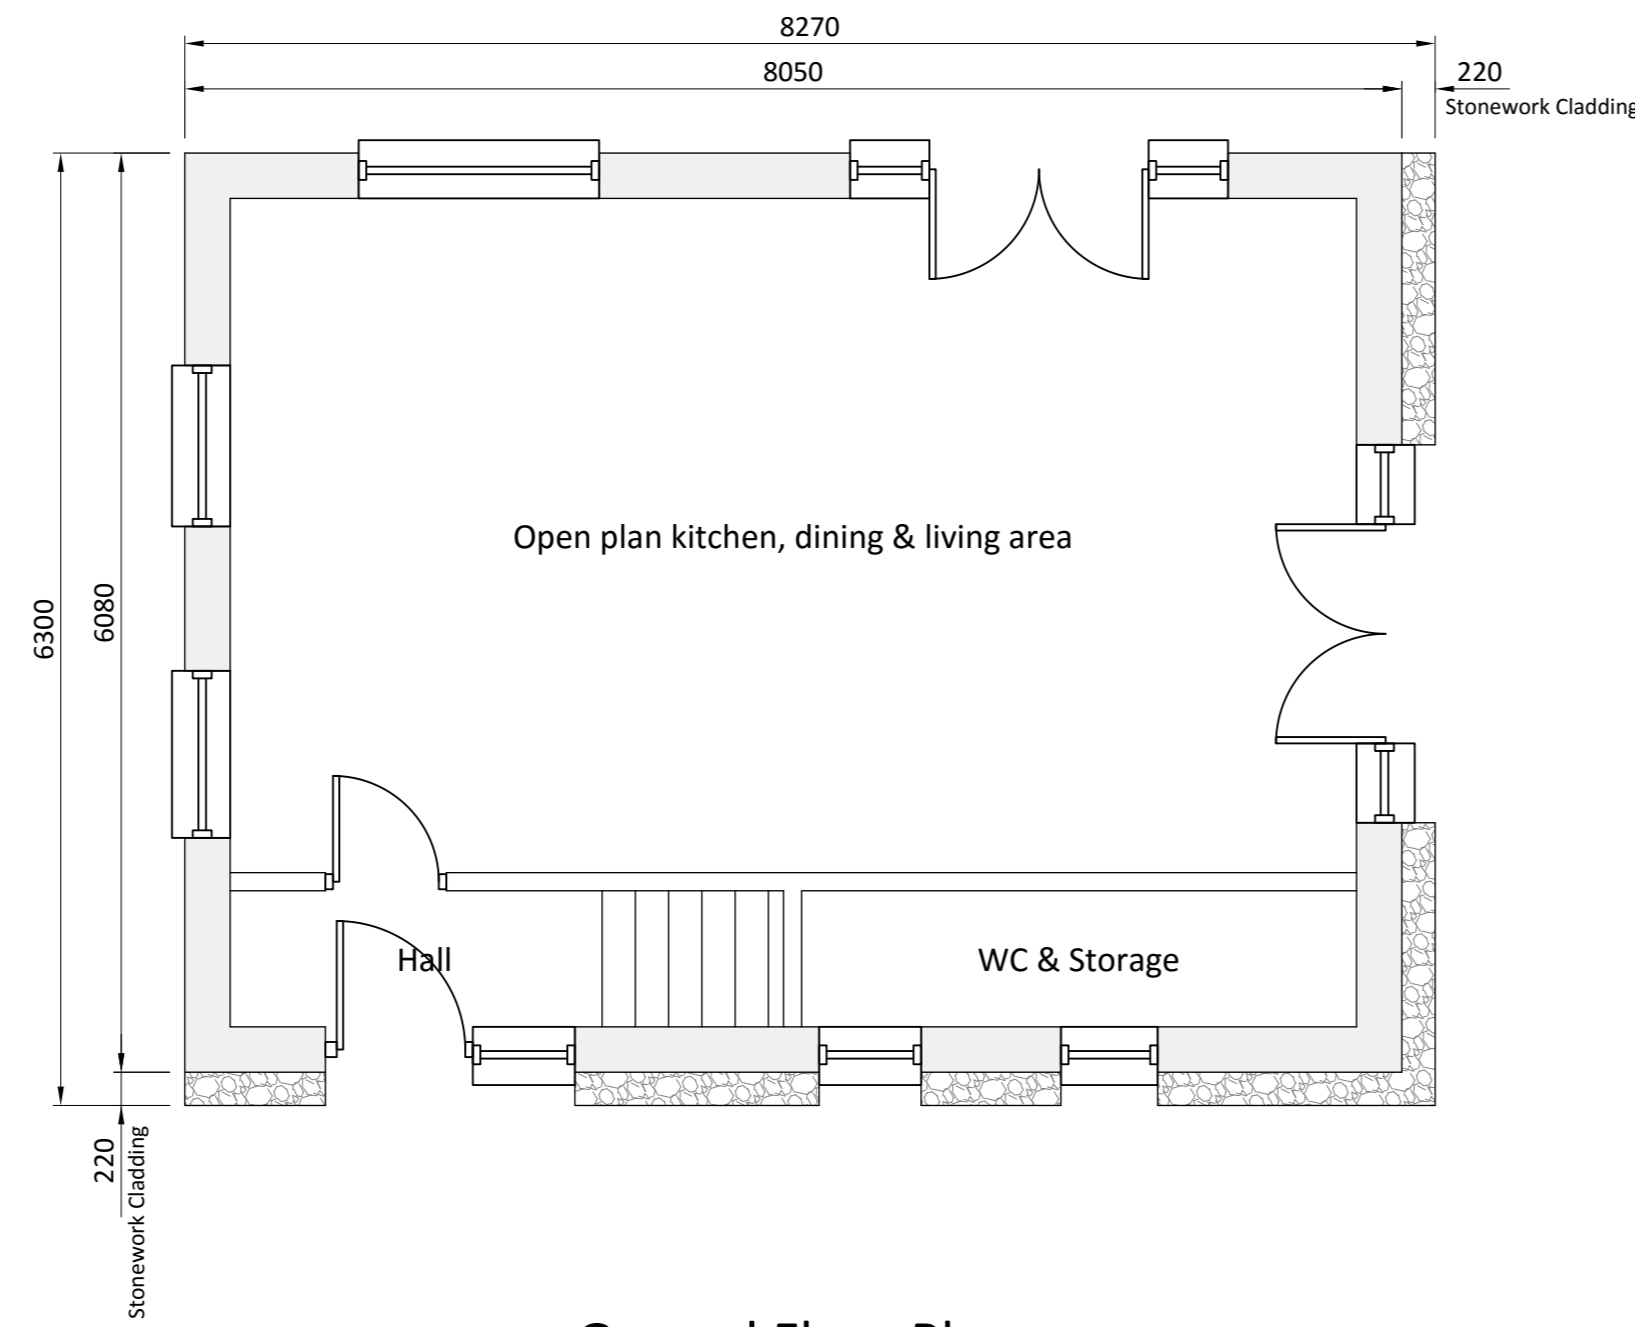


Ground Floor Plan

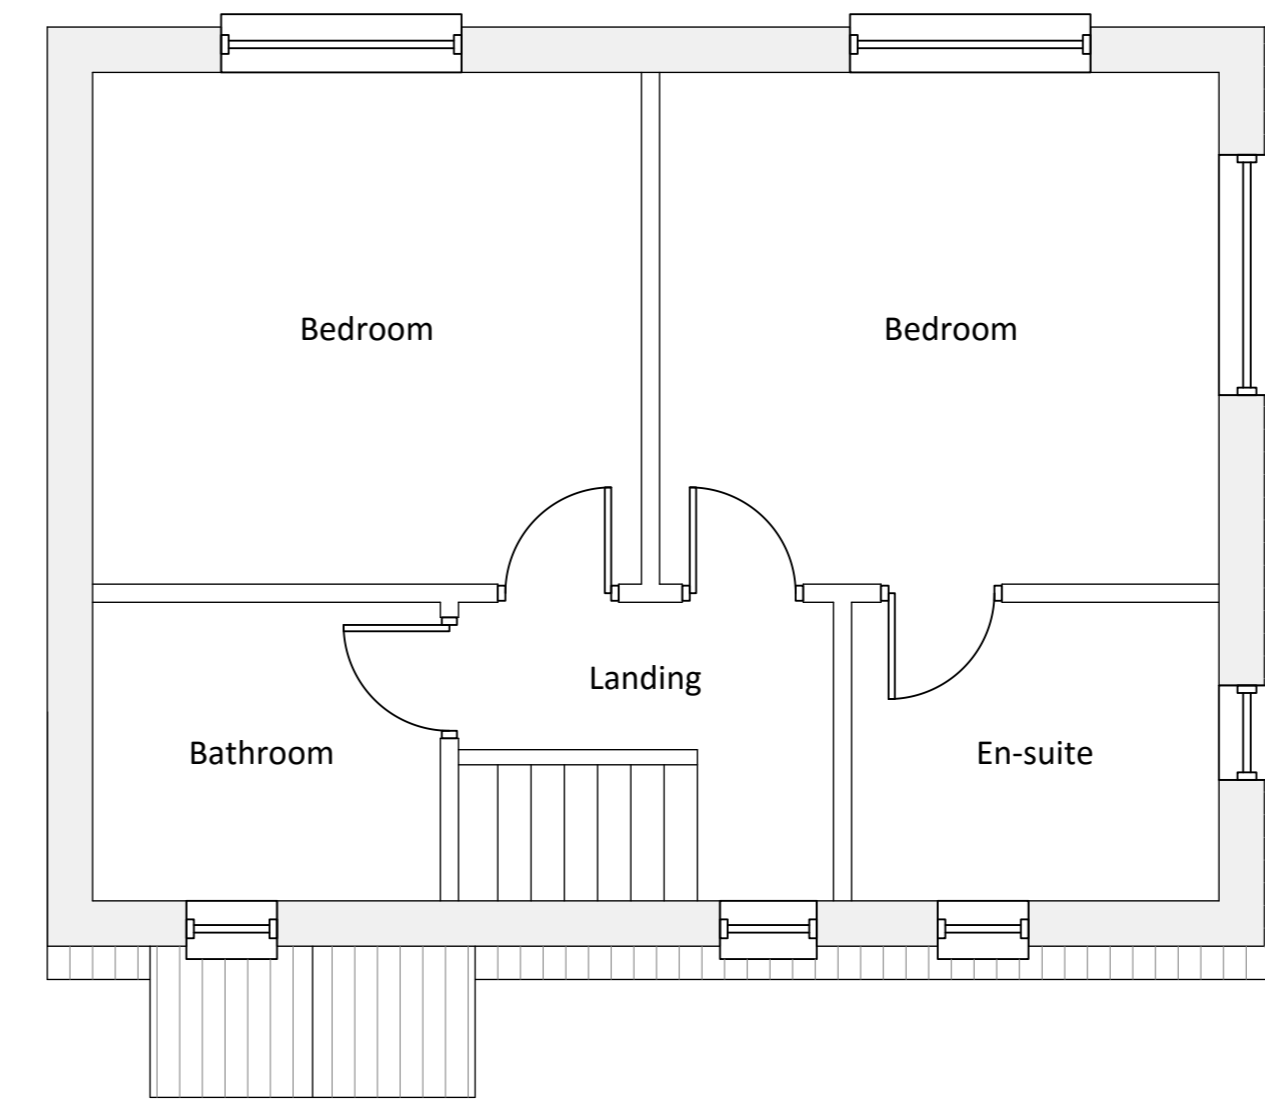


First Floor Plan




Side Elevation
On Arrow A

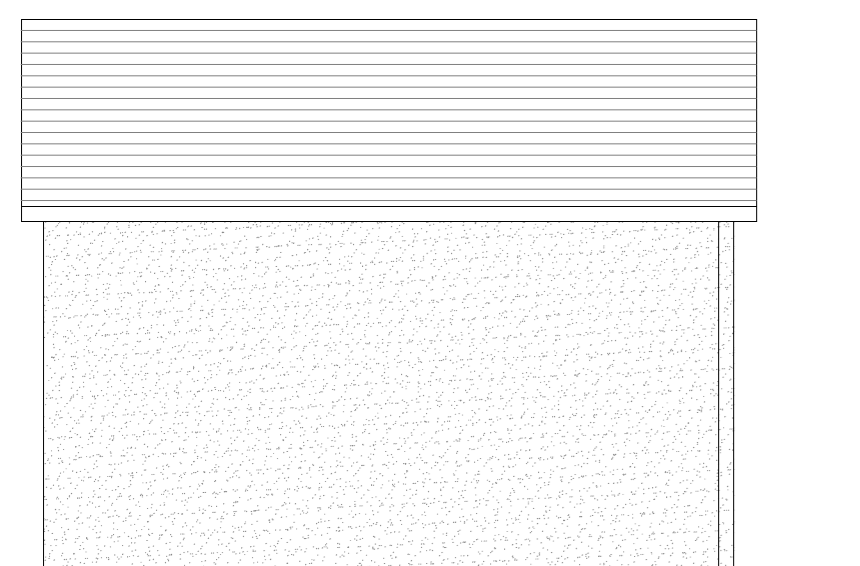


Side Elevation

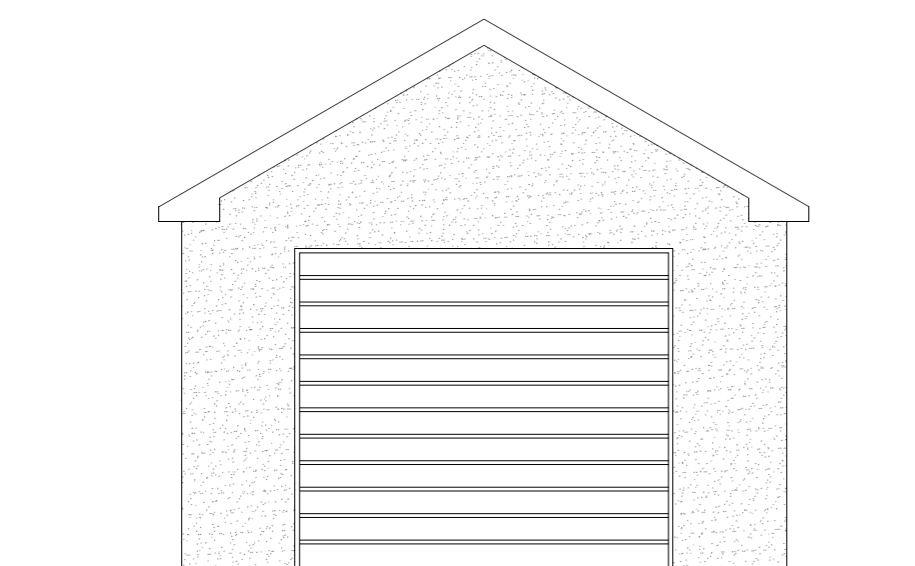


Front Elevation

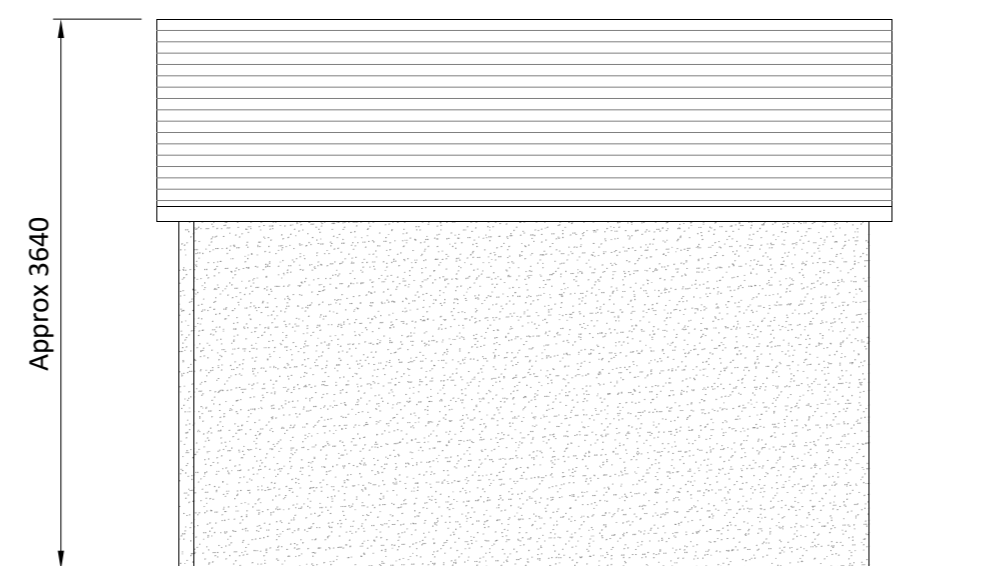

Side Elevation

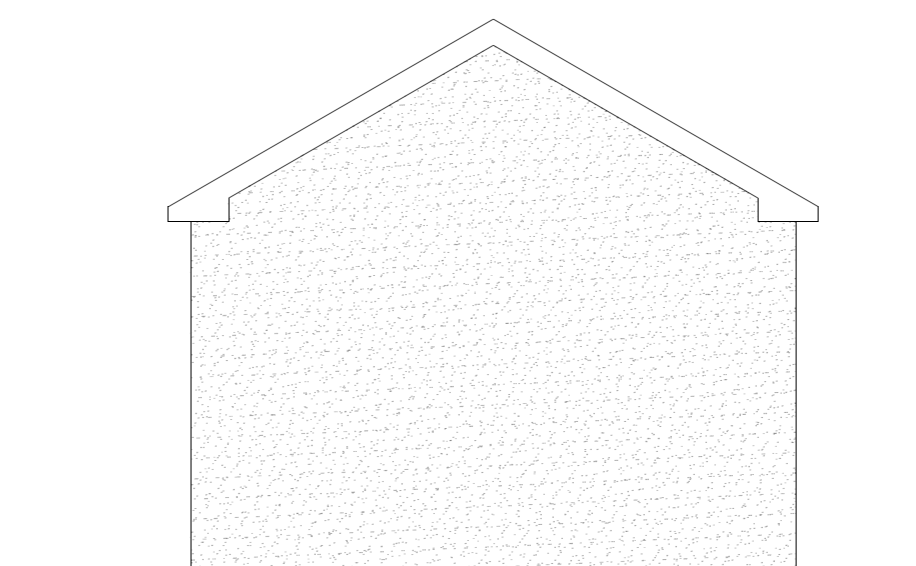

Rear Elevation

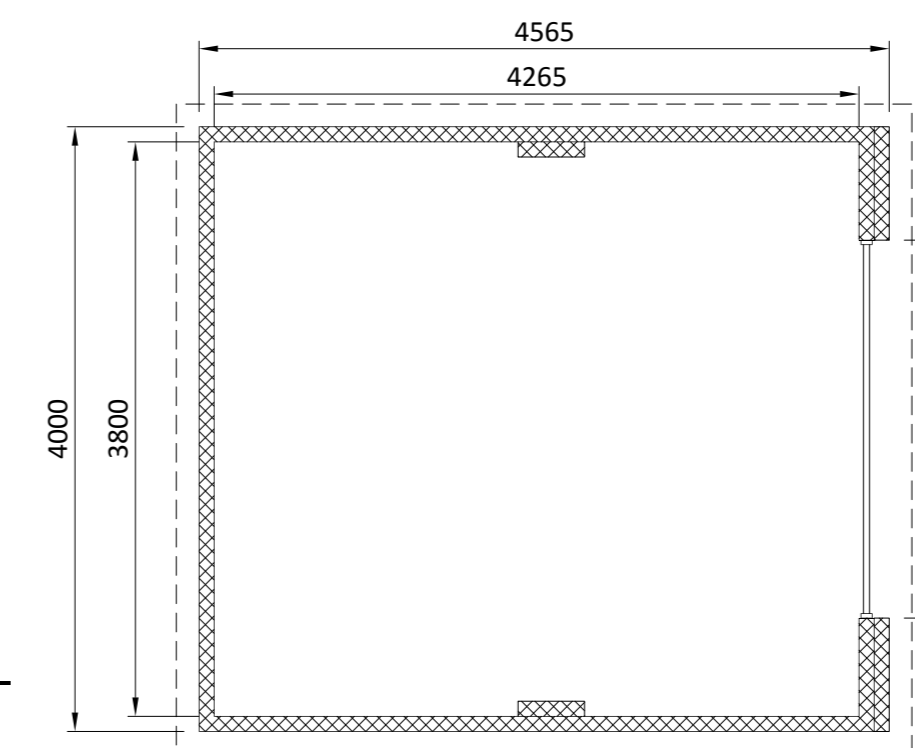

Plan

FINISHES SCHEDULE - HOUSE

CAVITY WALL CONSTRUCTION WITH CONCRETE RENDER & STONE WORK
CLADDING - SEE DRAWING
ROOF COVERING TO BE SLATE EFFECT (OR SIMILAR)
ALL WINDOWS & DOORS WHITE UPVC DOUBLE GLAZED UNITS
FACIAS WHITE UPVC & RAINWATER GOODS BLACK UPVC

FINISHES SCHEDULE - GARAGE

SINGLE SKIN DENSE CONCRETE BLOCK CONSTRUCTION WITH CONCRETE RENDER
ROOF COVERING TO BE SLATE EFFECT (OR SIMILAR) MATCHING HOUSE
FACIAS WHITE UPVC & RAINWATER GOODS BLACK UPVC
ROLLER SHUTTER GARAGE DOOR.

CLIENT: Mr E L Gibbon
ADDRESS: Collie Cottage
Cardiff Road, Dinas Powys,
Vale of Glamorgan
CF64 4LJ
PROPOSAL: 2 Bed Detached House & Detached Garage
As Built Plans & Elevations
DATE: Sept 2017
SCALE: 1:50 @ A1
PLANNING REF: 2017/00539/FUL

AS BUILT