


Site Plan
Scale 1:200

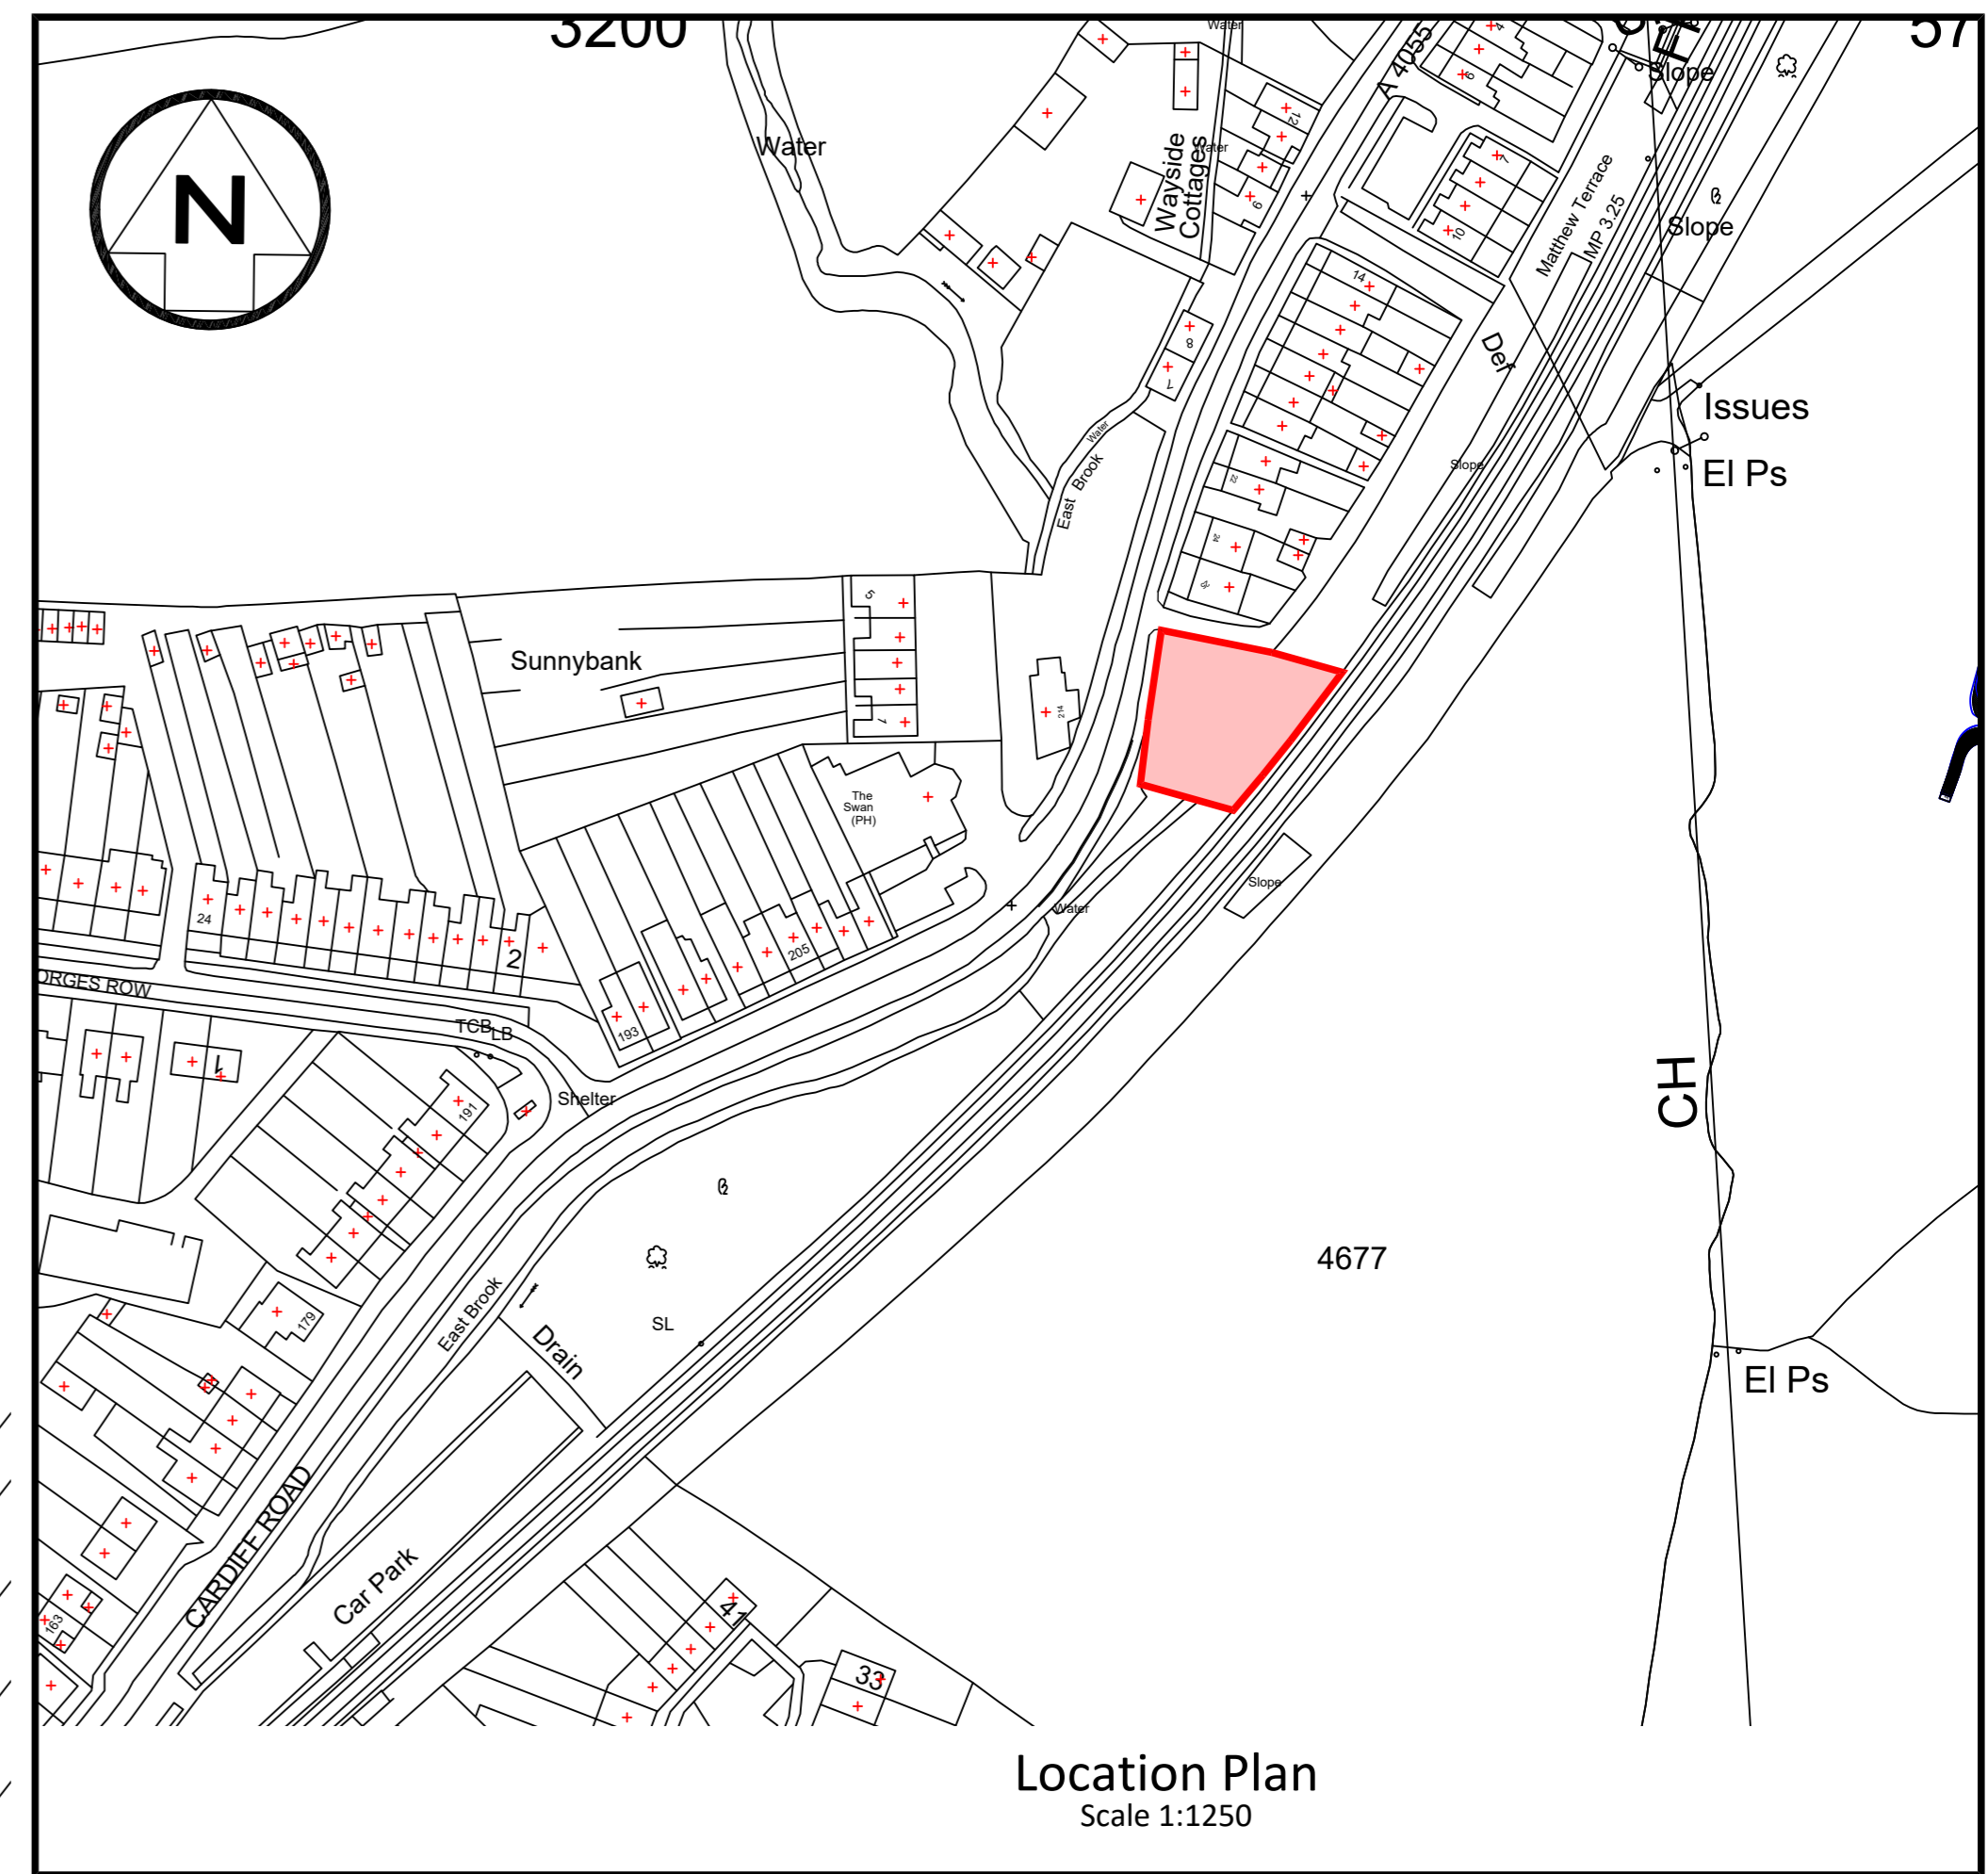

Location Plan
Scale 1:1250

AS BUILT

- CLIENT: Mr E L Gibbon
- ADDRESS: Collie Cottage
Cardiff Road, Dinas Powys,
Vale of Glamorgan
CF64 4LJ
- PROPOSAL: 2 Bed Detached House & Detached Garage
As Built Site Location Plan
- DATE: Sept 2017
- SCALE: 1:200 & 1:1250 @ A1
- PLANNING REF: 2017/00539/FUL
- REV 1: Site boundary line updated
- REV 2: Scale changed. Vision splay amended.
- REV 3: Drawing updates
- REV 4: Drawing updated with survey / setting out
information from Tony King Architects
approved outline planning drawing no.
L000 A 001 Rev E