

RECEIVED
26 FEB 2007
ENVIRONMENTAL
AND ECONOMIC
REGENERATION

THE VALE OF
GLAMORGAN COUNCIL
TOWN AND COUNTRY PLANNING ACT 1990
APPROVED
SUBJECT TO COMPLIANCE WITH CONDITIONS (IF ANY)
D.R. Thomas
HEAD OF PLANNING AND TRANSPORTATION

LEGEND

- Orange circle: Approximate location and area of untreated Giant and Japanese Knotweed (Updated July 2006).
- Green circle: Approximate location and area of Giant and Japanese Knotweed undergoing treatment (Updated July 2006).
- Orange dashed line: Standoff distance of 7 metres to be observed (Updated July 2006).
- Red line: Development site boundary.
- 1 Northern open areas.
- 2 Isolated area of knotweed adjacent to derelict flats and allotments.
- 3 Areas of knotweed adjacent to woodland edges.
- 4 Areas of knotweed adjacent to woodland edges.
- 5 Areas of knotweed on sloping ground to the north of Harbour View Road.
- 6 Isolated areas of knotweed on sloping ground to the north of Harbour View Road.
- 7 Isolated areas of knotweed adjacent to woodland edges.
- 8 Isolated areas of knotweed on the northern edge of the development boundary.
- 9 Areas of knotweed within the understorey of the ash trees.
- 10 Isolated areas of knotweed adjacent to the footpath leading into the bowl.
- 11 Knotweed within the disused play area.
- 12 Isolated knotweed areas adjacent to switchback footpath.
- 13 Isolated knotweed areas to the north of the main east-west woodland footpath.
- 14 Isolated areas of knotweed on sloping ground to the north of Harbour View Road.
- 15 Areas of knotweed to the east of the clump of ash trees.
- 16 Areas of knotweed adjacent to woodland edges.
- 17 Areas of knotweed adjacent to the switchback footpath.
- 18 Areas of knotweed on sloping ground to the north of Harbour View Road.


NOTE

-Areas 1-4 as identified by Wardell Armstrong (WA, June 2004).
-Areas 5-18 as identified by Nicholas Pearson Associates (NPA, May 2005/ Updated July 2006).
-Isolated areas of untreated knotweed persist in treated areas (NPA, May 2005/ Updated July 2006).
-Please refer to Complete Weed Control (South Wales) Ltd for details of the ongoing knotweed treatment.

Comments on knotweed treatment (July 2006)

- (1) Area treated with minimal knotweed regeneration.
(2) Area treated with sparse single stem knotweed regeneration.
(3) Area treated with clumps of knotweed regenerating.
(4) Area treated with persistent knotweed regeneration.

Area No.	Area Description	Identified by	Knowned undergoing treatment	Comments on treatment (July 2006)
1a	Northern open areas	WA	Yes - April 05	3
1b	"	WA	Yes - April 05	4
1c	"	WA	Yes - April 05	2
2a	Isolated areas of knotweed adjacent to derelict flats and allotments	WA	Yes - August 04	2
2b	"	WA	Yes - August 04	2
2c	"	WA	Yes - August 04	2
2d	"	WA	Yes - August 04	2
3	Areas of knotweed adjacent to woodland edges	WA	Yes - April 05	3
4a	"	WA	Yes - Sept 05	3
4b	"	WA	Yes - August 04	4
5	Knowned on sloping ground to the north of Harbour View Road	NPA	Yes - August 04	3
6a	Isolated knotweed areas on sloping ground to the north of Harbour View Road	NPA	Yes - July 05	3
6b	"	NPA	Yes - April 06	3
6c	"	NPA	Yes - April 06	2
7	Isolated areas of knotweed adjacent to woodland edges	NPA	Yes - Sept 05	3
8a	Isolated areas of knotweed on northern edge of the development boundary	NPA	Yes - July 05	3
8b	"	NPA	Yes - July 05	3
8c	"	NPA	Yes - July 05	3
8d	"	NPA	Yes - July 05	2
8e	"	NPA	Yes - July 05	3
8f	"	NPA	Yes - July 05	2
8g	"	NPA	Yes - July 05	3
8h	"	NPA	Yes - July 05	3
8i	"	NPA	Yes - July 05	3
9	Areas of knotweed within the understorey of the ash trees	NPA	Yes - Sept 05	3
10	Isolated areas of knotweed adjacent to footpath leading into the bowl	NPA	Yes - July 05	3
11	Knowned within disused play area	NPA	Yes - April 06	2
12a	Isolated knotweed areas adjacent to the switchback footpath	NPA	Yes - Sept 05	3
12b	"	NPA	Yes - Sept 05	3
13a	Isolated knotweed areas to the north of the main east-west woodland footpath	NPA	Yes - Sept 05	2
13b	"	NPA	Yes - Sept 05	2
13c	"	NPA	Yes - Sept 05	2
14a	Isolated knotweed areas on sloping ground to the north of Harbour View Road	NPA	Yes - April 06	2
14b	"	NPA	Yes - April 06	2
14c	"	NPA	Yes - April 06	2
14d	"	NPA	Yes - April 06	2
15a	Areas of knotweed to the east of the clump of ash trees	NPA	Yes - April 06	3
15b	"	NPA	Yes - April 06	3
16	Areas of knotweed adjacent to woodland edges	NPA	Yes - April 06	1
17a	Areas of knotweed adjacent to the switchback footpath	NPA	Yes - July 06	4
17b	"	NPA	Yes - July 06	4
18	Knowned on sloping ground to the north of Harbour View Road	NPA	Yes - July 06	3

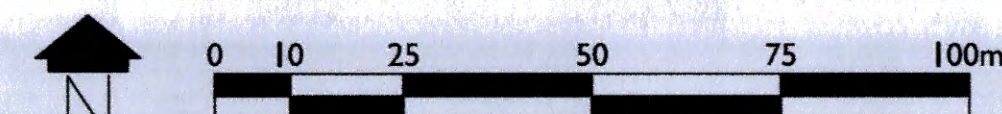

0700295 FUL

NICHOLAS PEARSON ASSOCIATES
ENVIRONMENTAL PLANNERS • LANDSCAPE ARCHITECTS • ECOLOGISTS

Client CREST NICHOLSON

Project PENARTH HEIGHTS,
VALE OF GLAMORGAN

Drawing JAPANESE AND GIANT KNOTWEED CONTROL
PROGRESS PLAN

Status PLANNING

Date 20/05/05 Prepared RF Checked SK Approved SK

Scale 1:1000@A1 Drawing No. NPA 10050 202 Drawn RF Rev

Head Office: 30 Brock Street Bath BA1 2LN United Kingdom Tel: +44 (0) 1225 445548 Fax: +44 (0) 1225 312387

All discrepancies or queries regarding this drawing should be referred to Nicholas Pearson Associates Ltd. Nicholas Pearson Associates Ltd accept no liability for any expense, loss or damage of whatsoever nature and however arising from any variation made to this drawing or in the execution of the work, to which it relates which has not been referred to them and their approval obtained.

Dwg Ref: