


THE VALE OF
GLAMORGAN COUNCIL
TOWN AND COUNTRY PLANNING ACT 1990
APPROVED
SUBJECT TO COMPLIANCE WITH CONDITIONS (IF ANY)

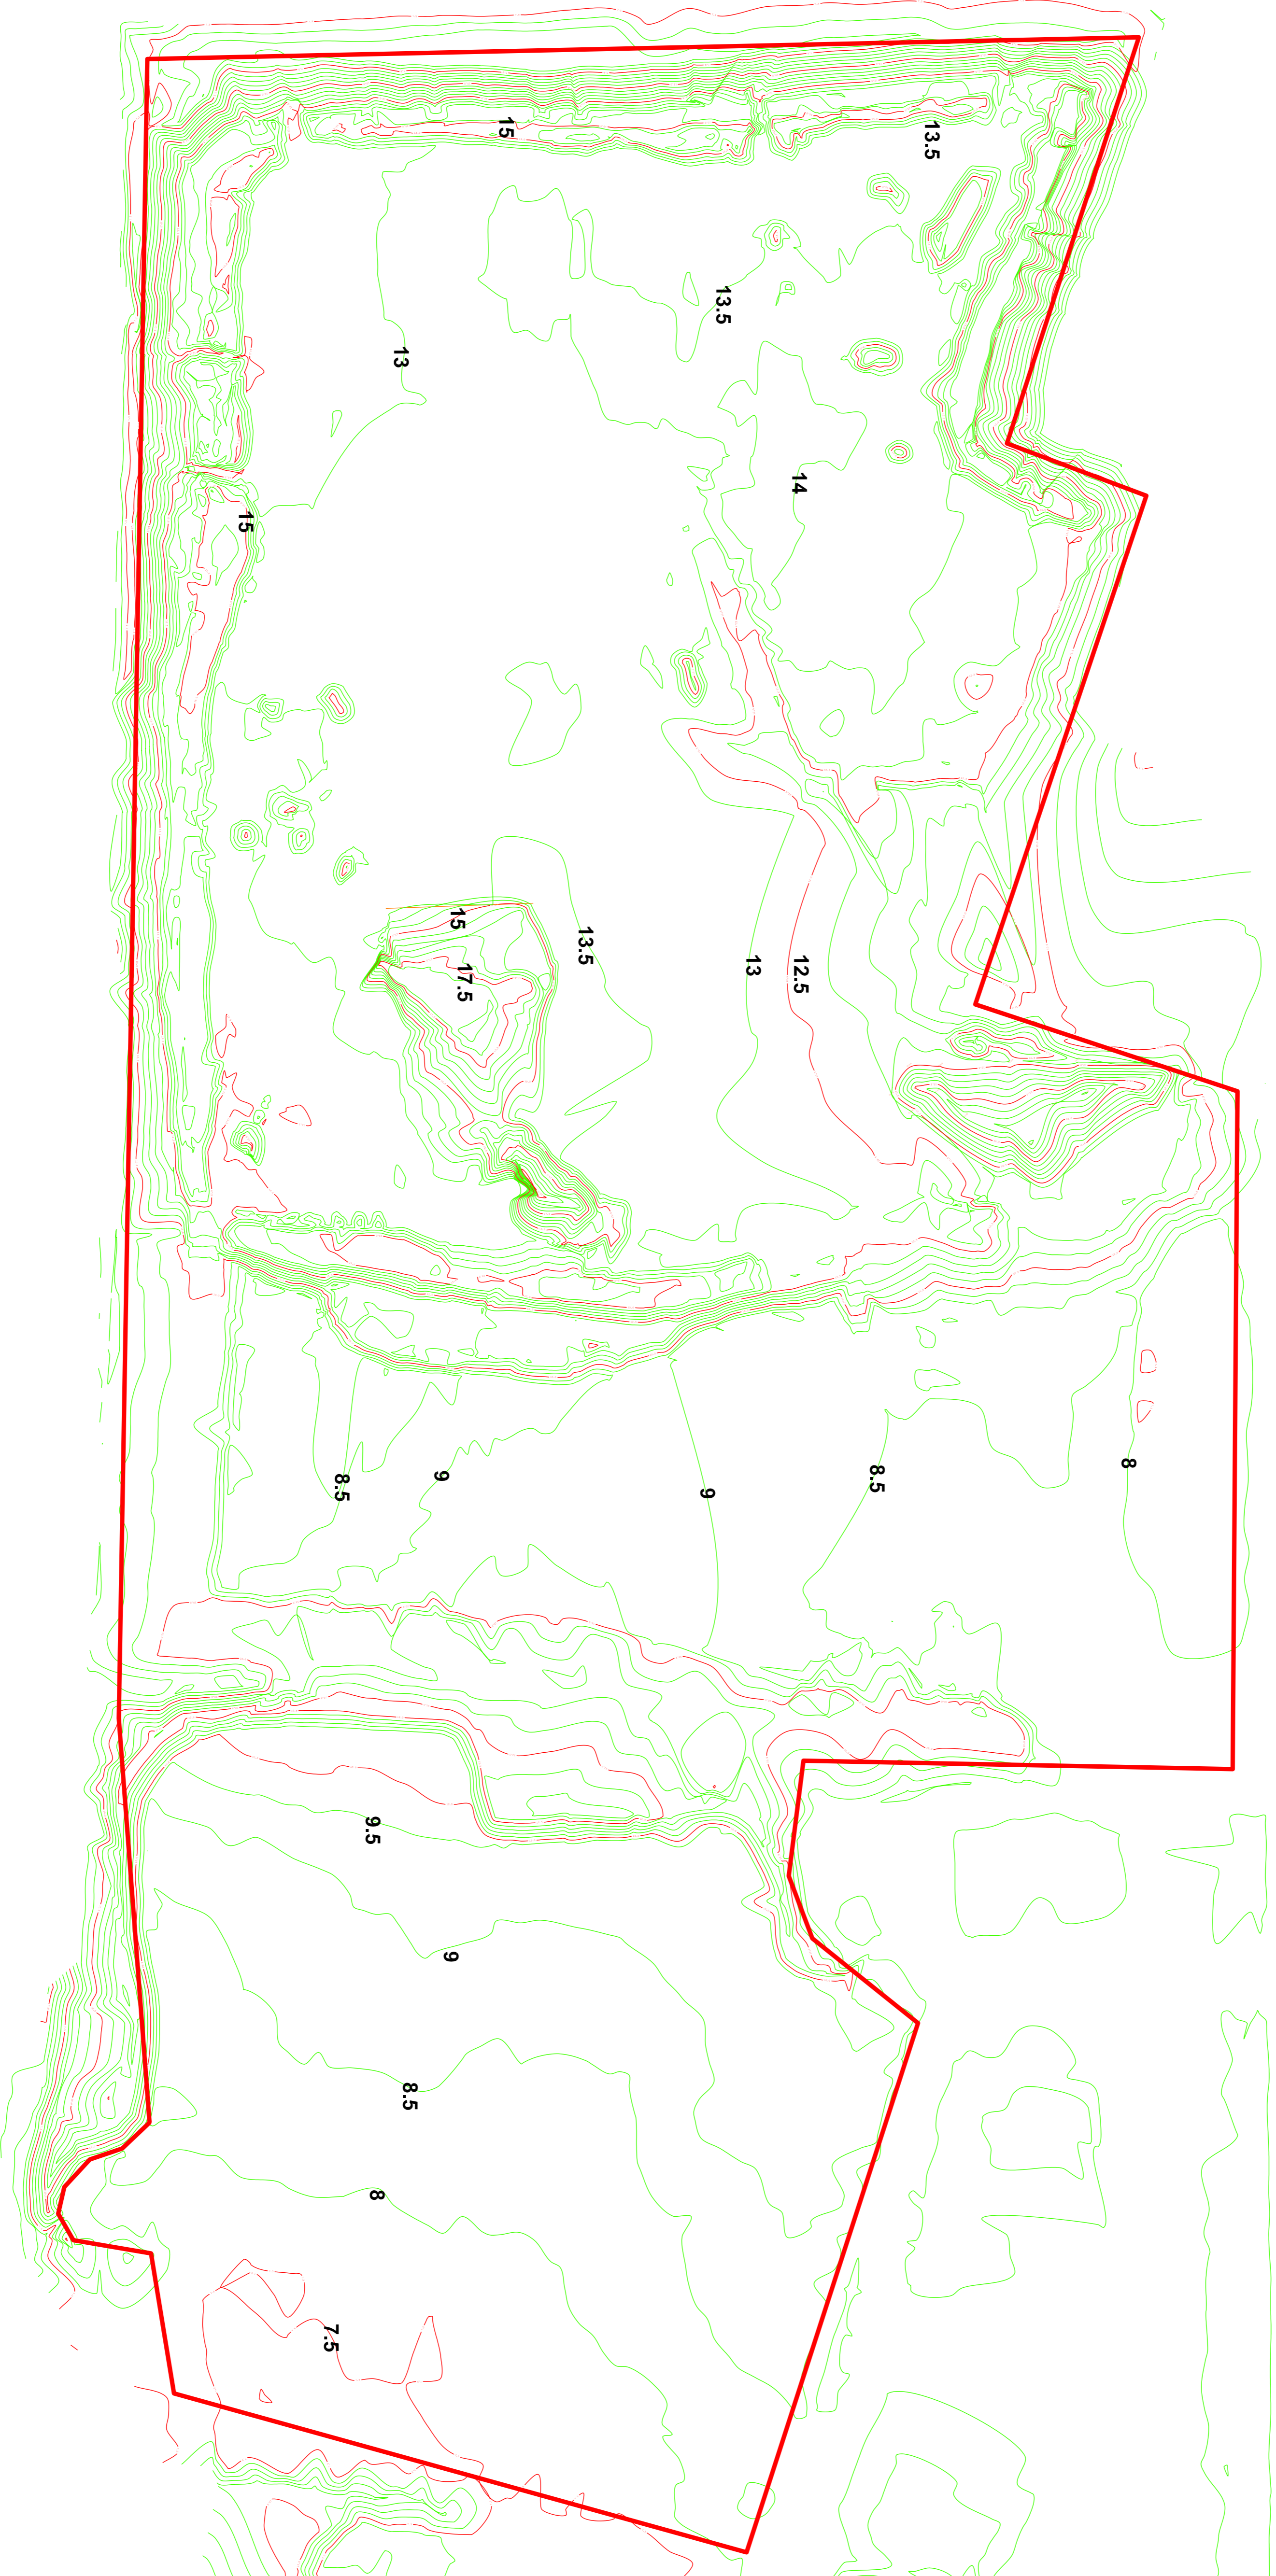

— Red line Boundary

Notes:

A1

Job: 234-02-11

Title: December Updated Existing Levels

Date: January 2015

Scale: 1:750 @A1

Drawn by: DS

Checked by: AP


ExCAL House,
Capel Hendre Ind. Est.,
Ammantford,
Carmarthenshire,
SA18 3SJ
Tel: 01269 831606
Fax: 01269 841867
Website: www.excaluk.com
E-mail: info@excaluk.com

Drawing No: 234-02-11.d11

Revision No: Date: