




ORIGINAL FRONT ELEVATION  
Scale 1:50

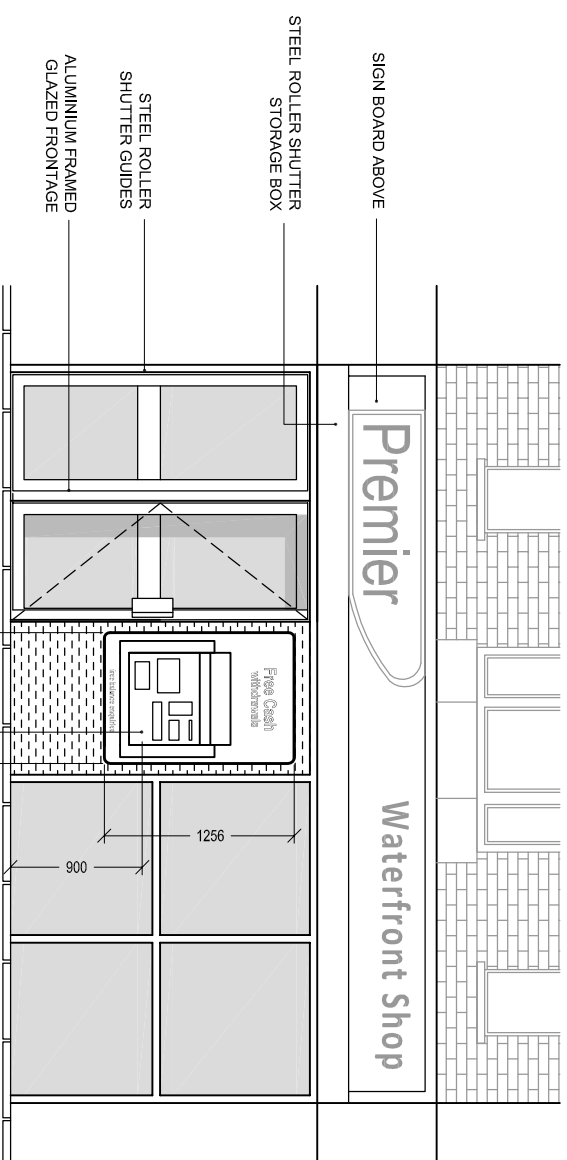

AS INSTALLED FRONT ELEVATION  
Scale 1:50  
NEW ATM INSTALLED THROUGH EXISTING WINDOW OPENING. GLAZING TO BE REPLACED WITH NEW STEEL SECURITY PANEL INSTALLED.

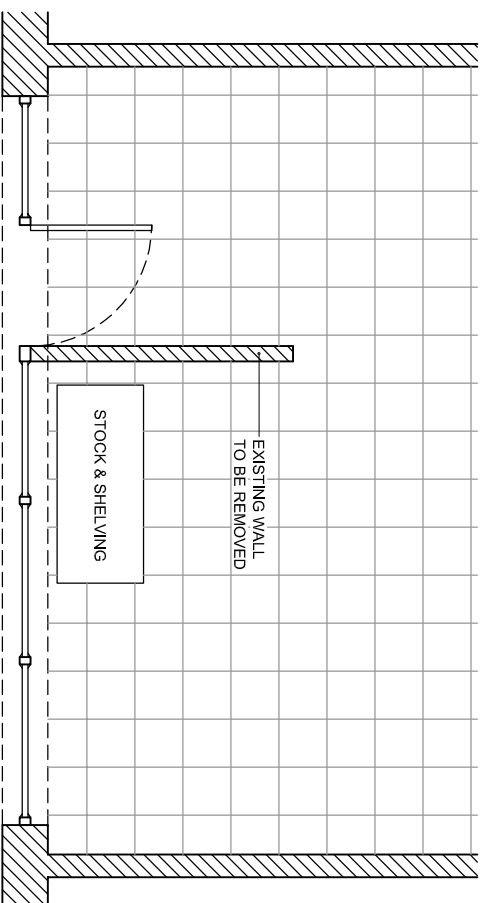

ORIGINAL PART PLAN  
Scale 1:50

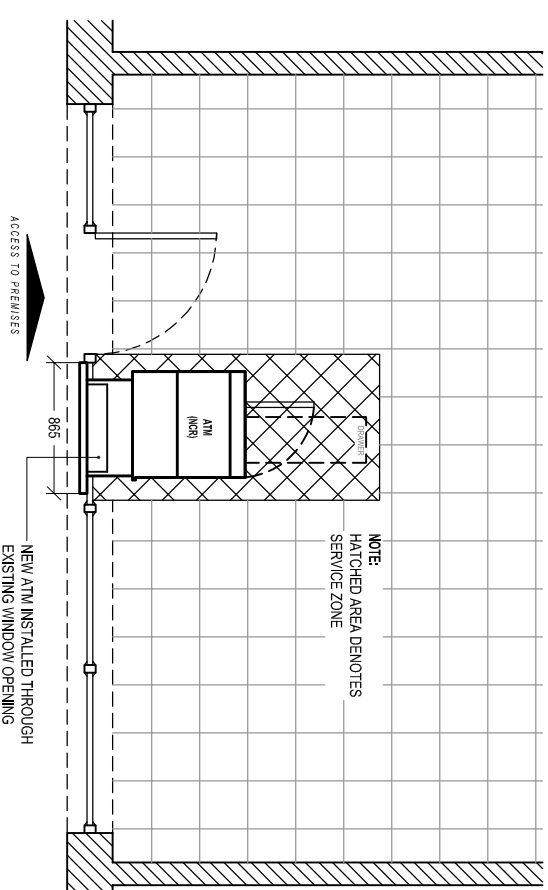

AS INSTALLED PART PLAN  
Scale 1:50

Date: \_\_\_\_\_  
Comments: \_\_\_\_\_  
By: \_\_\_\_\_

GENERAL NOTES:  
1/ All dimensions in millimeters unless otherwise stated.

Site:  
**PREMIER**  
107 Broad Street  
Barry  
CF62 7AJ

Drawing Title:  
Original & As Installed Elevations and Plans

Ref:	Date:	Rev:
NM-10-2014-49	28-10-2014	
Scale:	Paper:	Date Rev:
1:50	A3	