




- ALL UNCOLOURED ROADWAYS - TARMAC
- BLOCK SETT PAVING
- GOLDEN GRAVEL
- PATHS - SANDSTONE AND CONCRETE SLABS
- COMMUNAL PATHS - EXPOSED AGGREGATE CONCRETE
- COSWOLD CHIPPIINGS
- COMMUNAL LANDSCAPED AREAS
- PRIVATE GARDEN SHRUB BEDS
- TIMBER FENCING
- GREEN PVC COATED CHAINLINK
- DWARF BRICK WALLS
- REAR OF PLOTS 7, 13 / 20, 24 / AND SOUTHERN AND WESTERN BOUNDARIES 625MM HIGH BRICK RETAINING WALLS WITH 725MM HIGH SLATED TIMBER FENCING ABOVE (NO VIEW THROUGH)

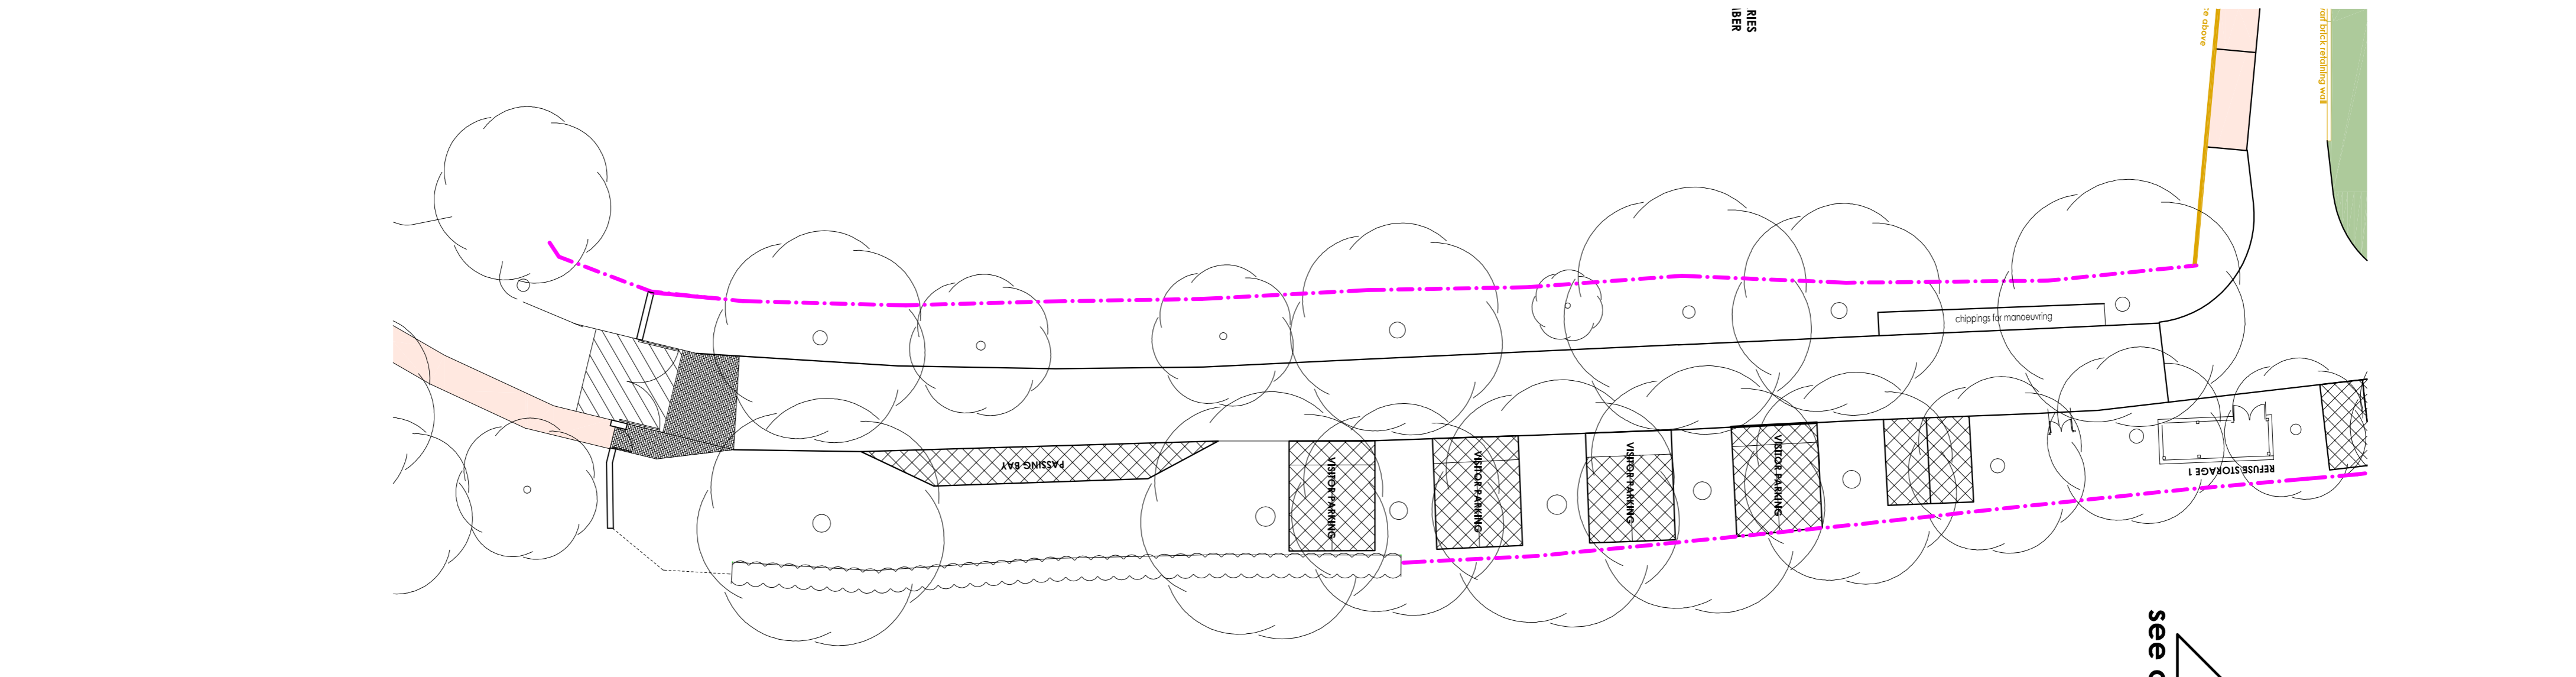

see continuation plan

Client	PORTABELLA		
Project	BRTMETHIN RETIREMENT HOUSING		
Title	RETENTION OF 24 PLOTS AS BUILT WITH REVISED PARKING AREAS		
State	Date	Scale	Drawing No.
Design	Mar 2017	1:250 @ A1	39314-AP32
Author	Checker	Scale	Rev

The Studio
 5 Remoth Road Lane,
 Parramatta, New South Wales, Australia
 Phone: +61 (0)2 9070 2800
 Email: e.studio@nigel-arnold.com

● nigel arnold / architect