


All timber in treated sw for staining with Soudin Classic - 2 coats, colour 'Dover Grey'  
 Posts ex 75 x 75mm sq min  
 Slats ex 75 x 19mm fixed both sides at staggered c/s

1500

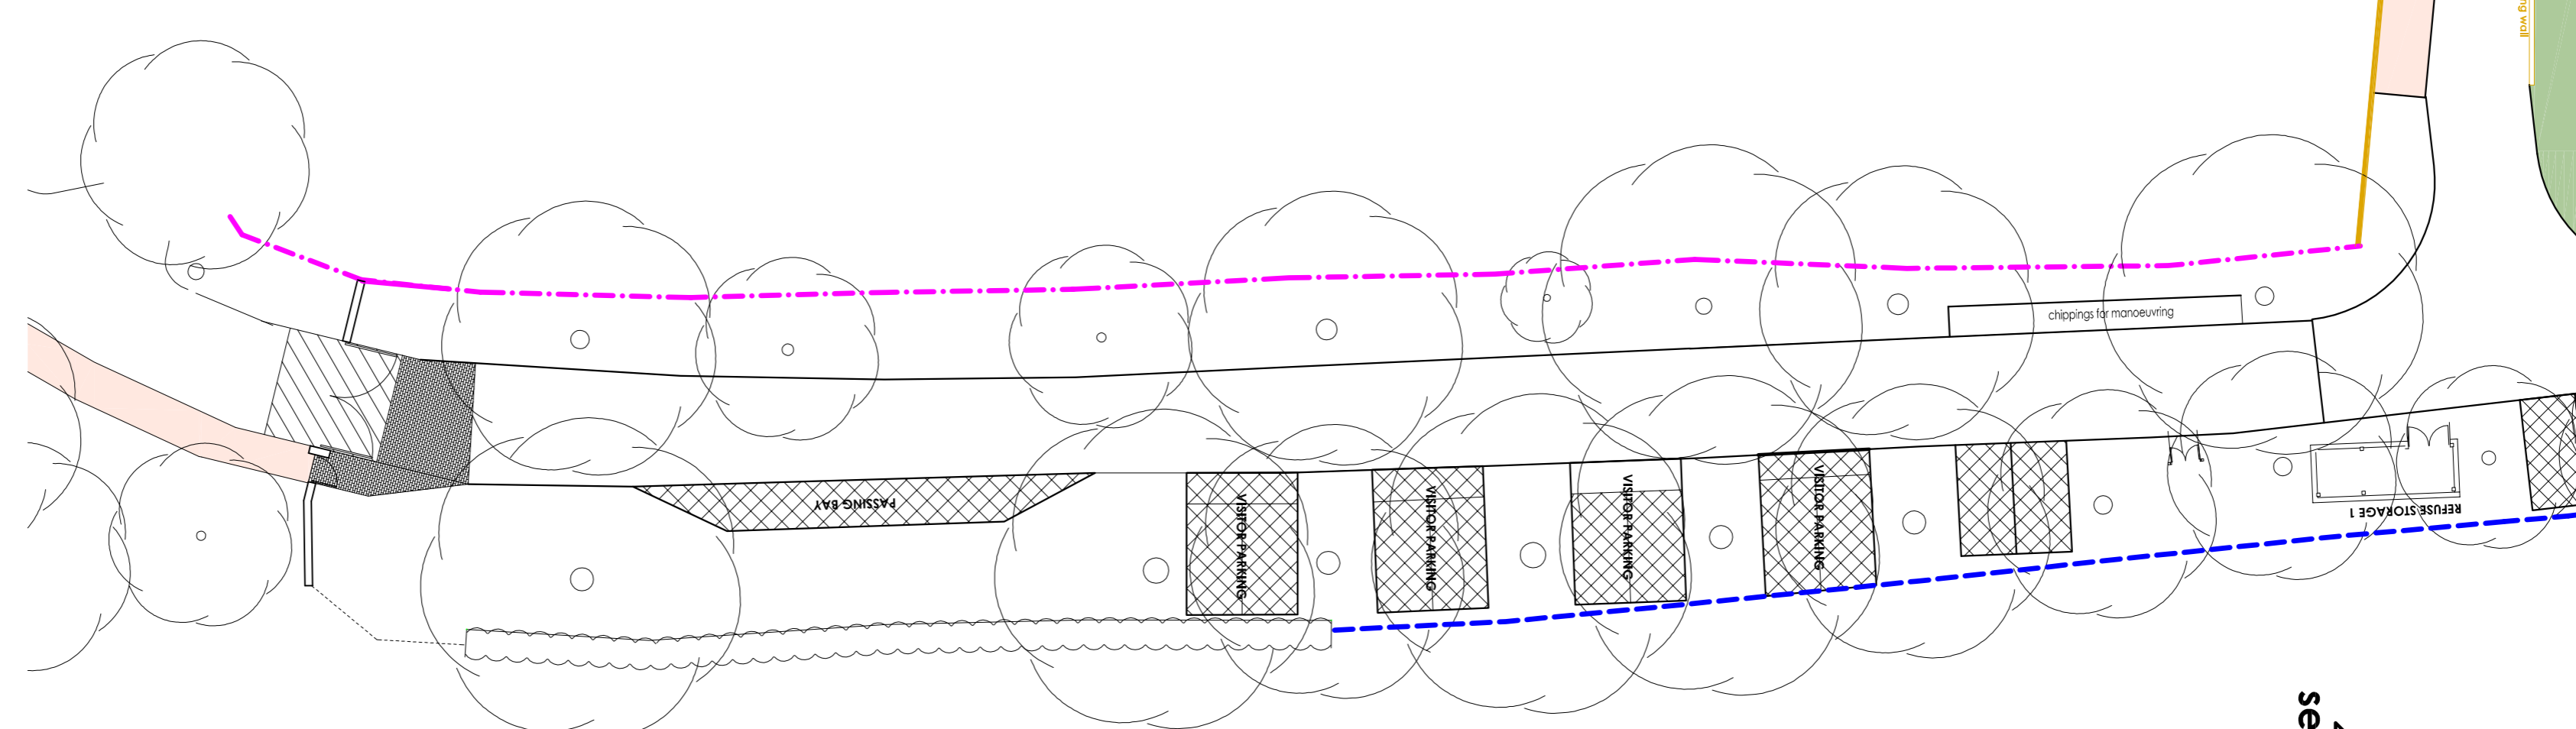

see continuation plan

Client	PORTABELLA		
Project	BRTMERTHIN RETIREMENT HOUSING		
Title	<b>RETENTION OF 24 PLOTS AS BUILT WITH REVISED PARKING AREAS</b>		
Stage	Date	Scale	Drawing No.
Design	Mar 2017	1:250 @ A1	<b>39314-AP32</b>
Sheet			Rev
			<b>A</b>

The Studio  
 5 Penarth Head Lane,  
 Penarth, Glamorgan, CF44 1BB  
 t: +44 (0)2070 2581  
 e: studio@nigel-arnold.com

● **nigel arnold / architect**