


Site Plan  
Scale 1:200

**AS BUILT**

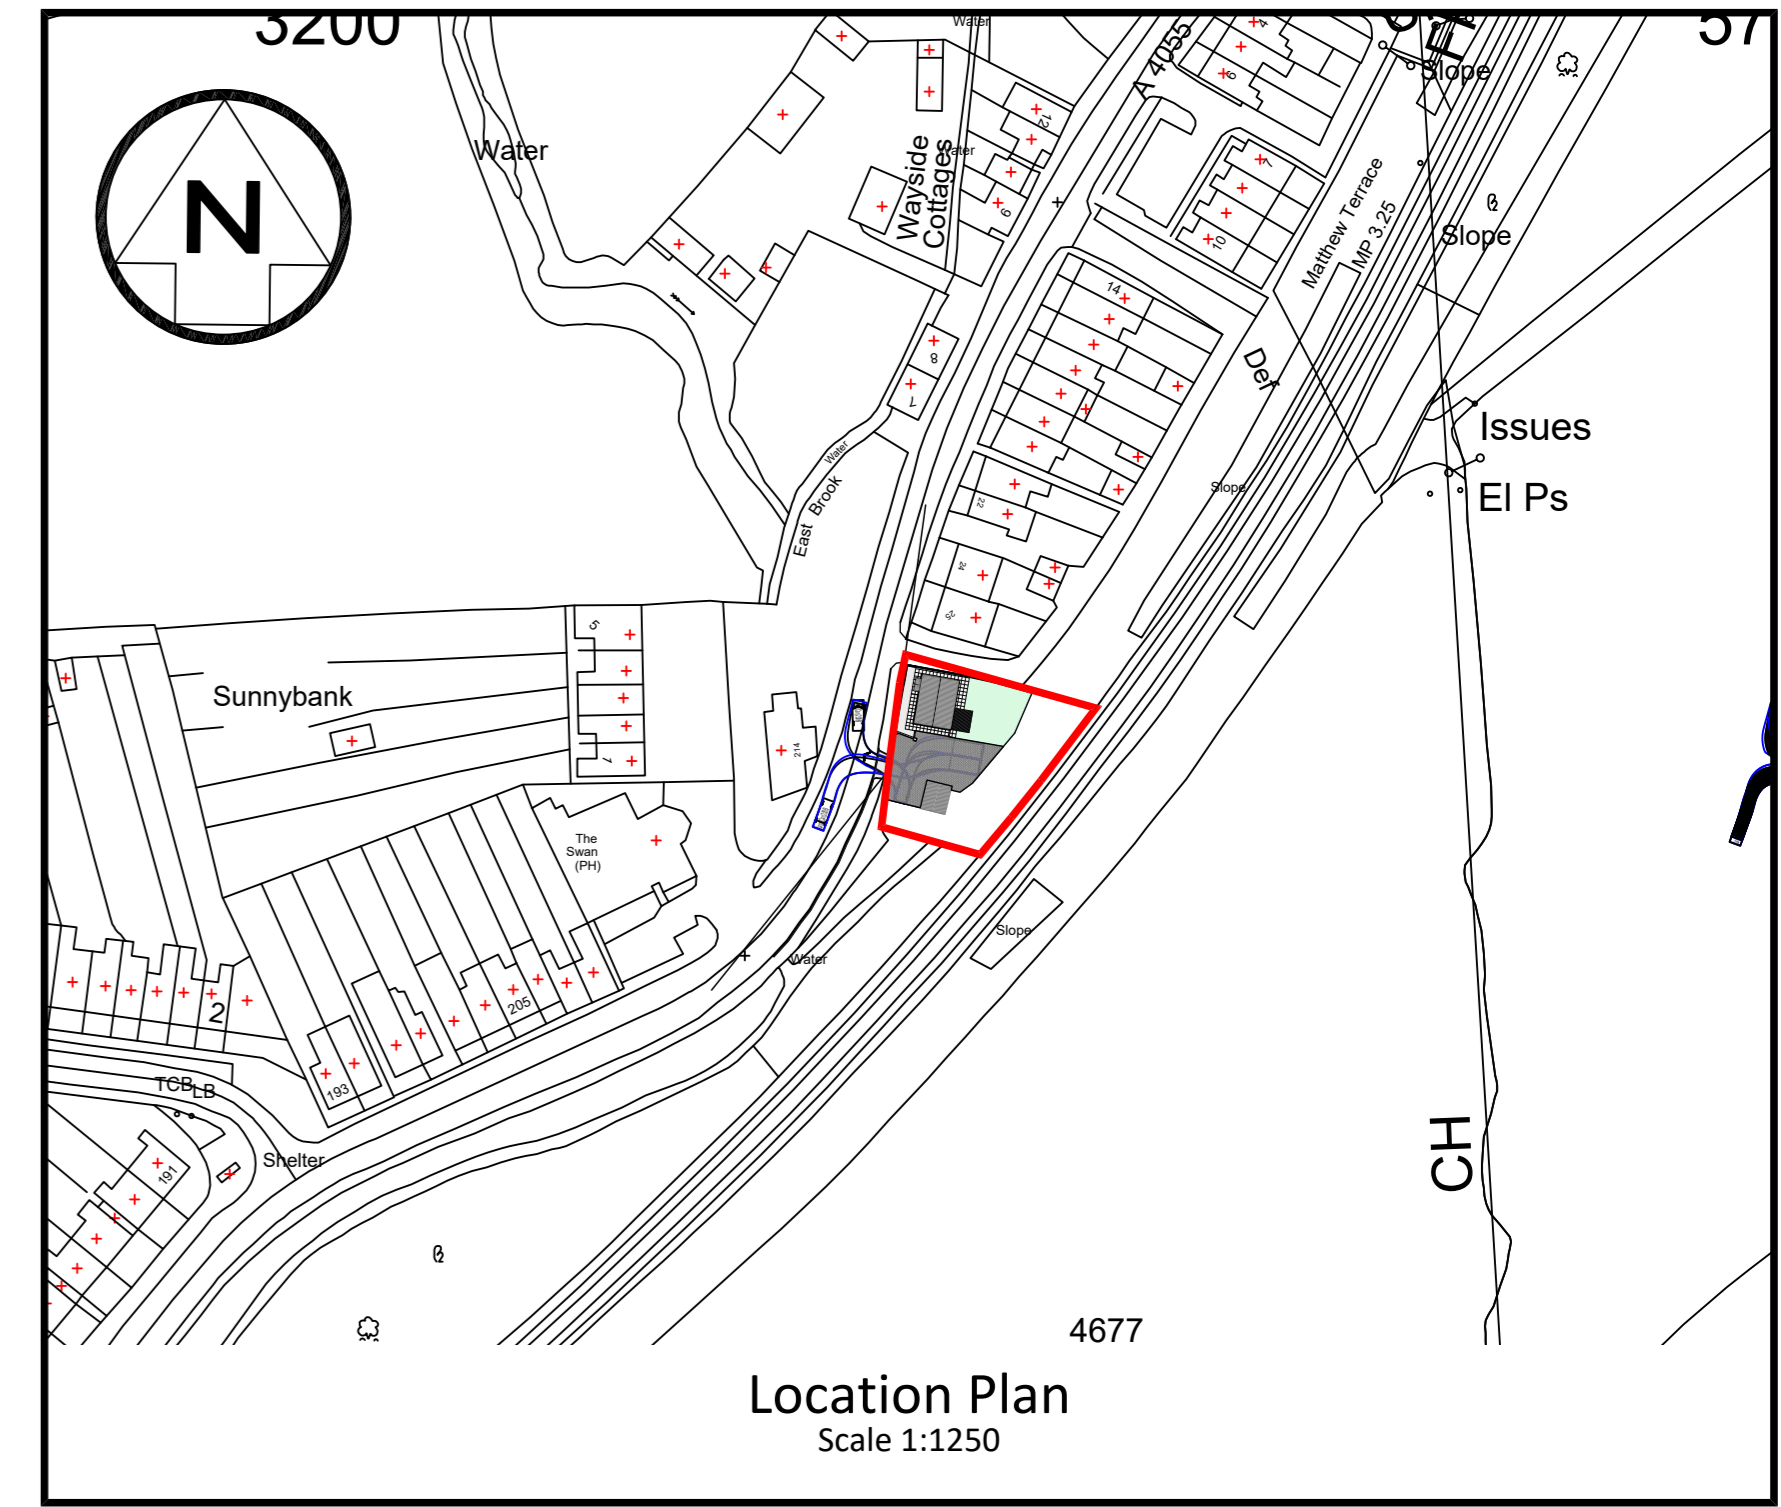

- CLIENT: Mr E L Gibbon
- ADDRESS: Collie Cottage  
Cardiff Road, Dinas Powys,  
Vale of Glamorgan  
CF64 4LJ
- PROPOSAL: 2 Bed Detached House & Detached Garage  
As Built Site Location Plan
- DATE: Sept 2017
- SCALE: 1:200 & 1:1250 @ A1
- PLANNING REF: 2017/00539/FUL
- REV 1: Site boundary line updated
- REV 2: Scale changed. Vision splay amended.
- REV 3: Drawing updates