



Front Elevation

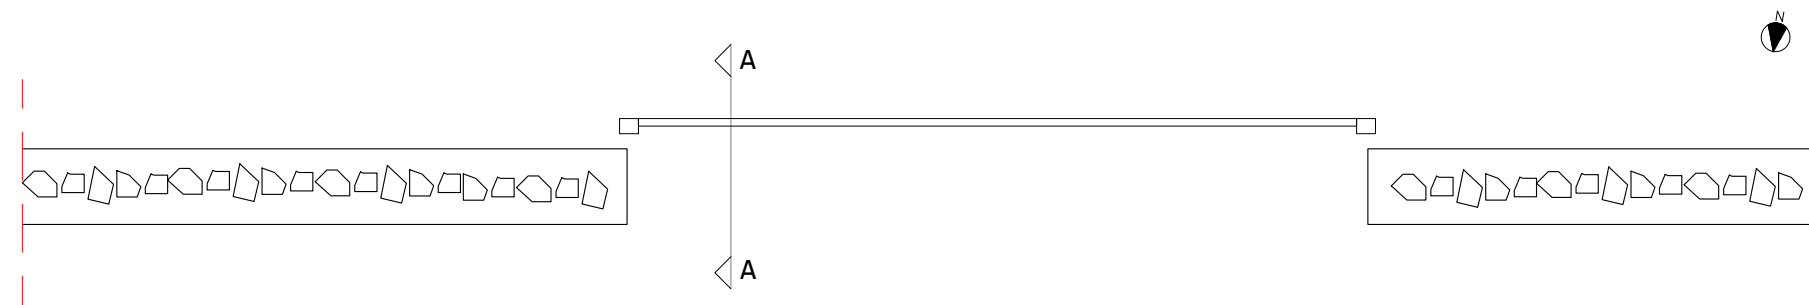

Plan

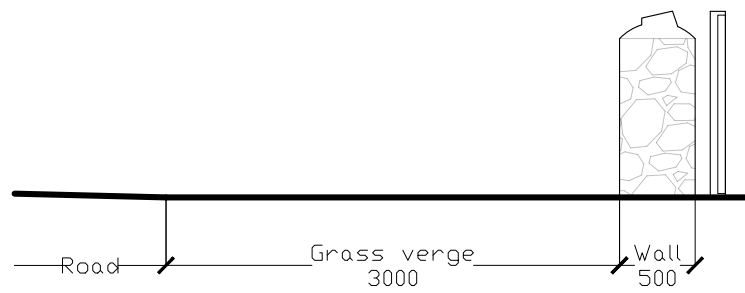

Section A-A

A S B U I L T

Location: Field access to the west of Village Farm, Colwinston
 Status: Enforcement
 Scale: 1:50 @ A3
 Drawing No: A01
 Revision: A
 Date: Sepetember 2023

